

OFFICE SPACE FOR LEASE




40 MAIN STREET CENTERBROOK, CT

- 4,000 s.f. of Office Space on Second Floor Only Available
- No Elevator
- Central HVAC
- Plenty of Open Parking
- Can be Subdivided
- Owner/Broker


\$11.95 s.f. NNN



Clark Development • P.O. Box 995 • Essex, CT 06426
Tel: 860-767-0000 Fax: 860-767-7124
Email: info@the-clark-group.com
www.the-clark-group.com

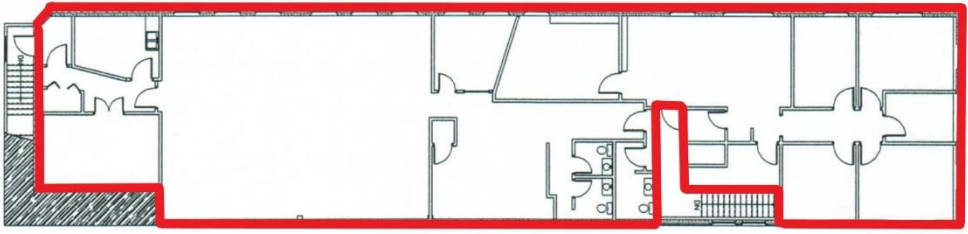

SECOND FLOOR PLAN
SCALE: 1/8"=1'-0"

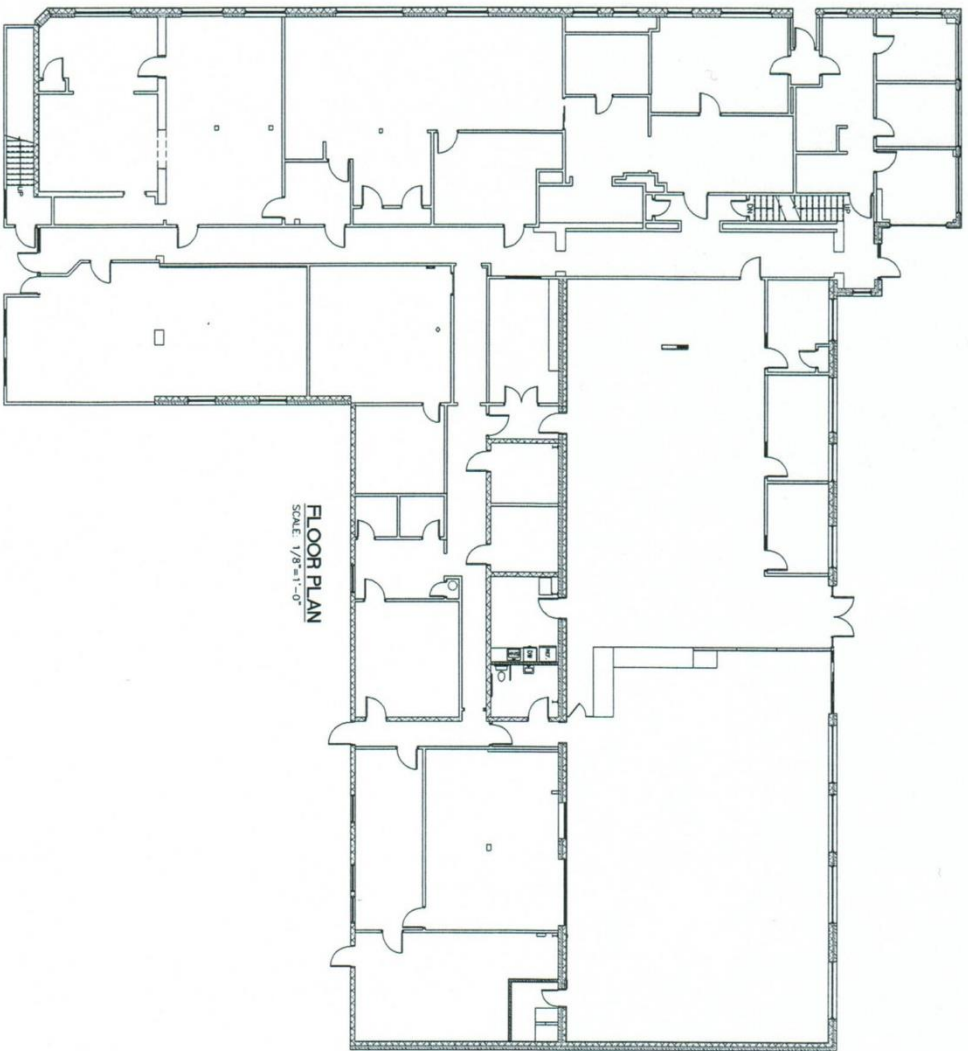

FIRST FLOOR PLAN
SCALE: 1/8"=1'-0"

FLOOR PLAN
SCALE: 1/8"=1'-0"

This drawing and details are prepared on the property of the architect and are not to be used for any other project without the written consent of the architect.



No.	1	1/10/2012	AS-BUILT
Date			Revision

R. Neil Hayes, Jr.
ARCHITECT

rhayes@rdhny.com
203-962-5020 (cell)

Project Title
EXISTING
CONDITIONS
for
40 MAIN STREET

40 MAIN STREET
CENTERTOWN, CT

Date
8/27/2012
Drawn/Checked
S. SHOWN / RHH

FLOOR PLANS

EX-1